

#8013

CURVE TABLE				
CURVE	DELTA	RADIUS	LENGTH	CHORD BR
C1	52°-53'-15"	65.00'	60.00'	N0°-34'-40"-E
C2	56°-14'-30"	25.00'	24.54'	N2°-15'-15"-E
C3	90°-00'-01"	25.00'	39.27'	N75°-22'-30"-E

PROPOSED LOT LINE TABLE		
LINE #	DIRECTION	LENGTH
P1	N9°-11'-29"-W	32.67
P2	N59°-49'-10"-W	98.38'
P3	N45°-59'-58"-W	32.53'
P4	N9°-25'-54"-E	99.04'
P5	N47°-07'-13"-E	148.25'
P6	S58°-20'-11"-E	95.29'


Received and approved 1/21/2022
for the Ulster County Health Department

SECTION: 108.2-9-41.71
LOCATION MAP SCALE: 1" = 2000'

Charles Smith
Public Health Director
Ulster County Health Department
Commissioner of Health


Recommended for Approval
CP
Trudy Romo, PE

N/P KRALIK & FORSYTH

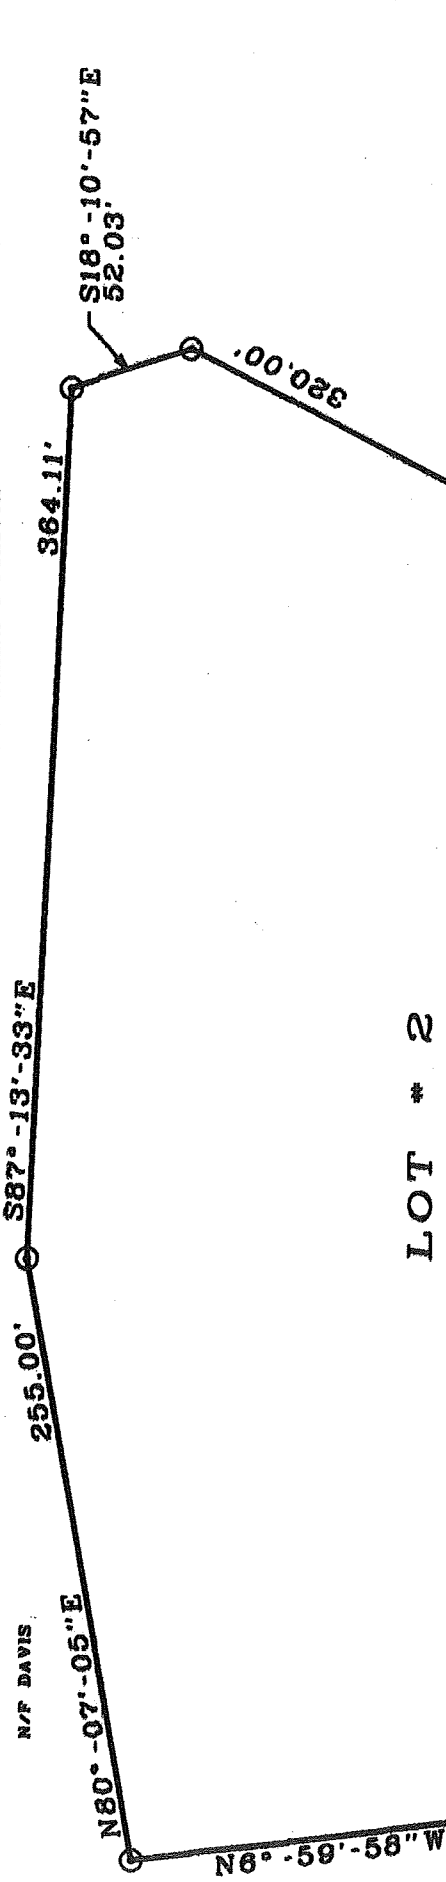


LOT # 2

RESERVE-SAME AS PRIMARY

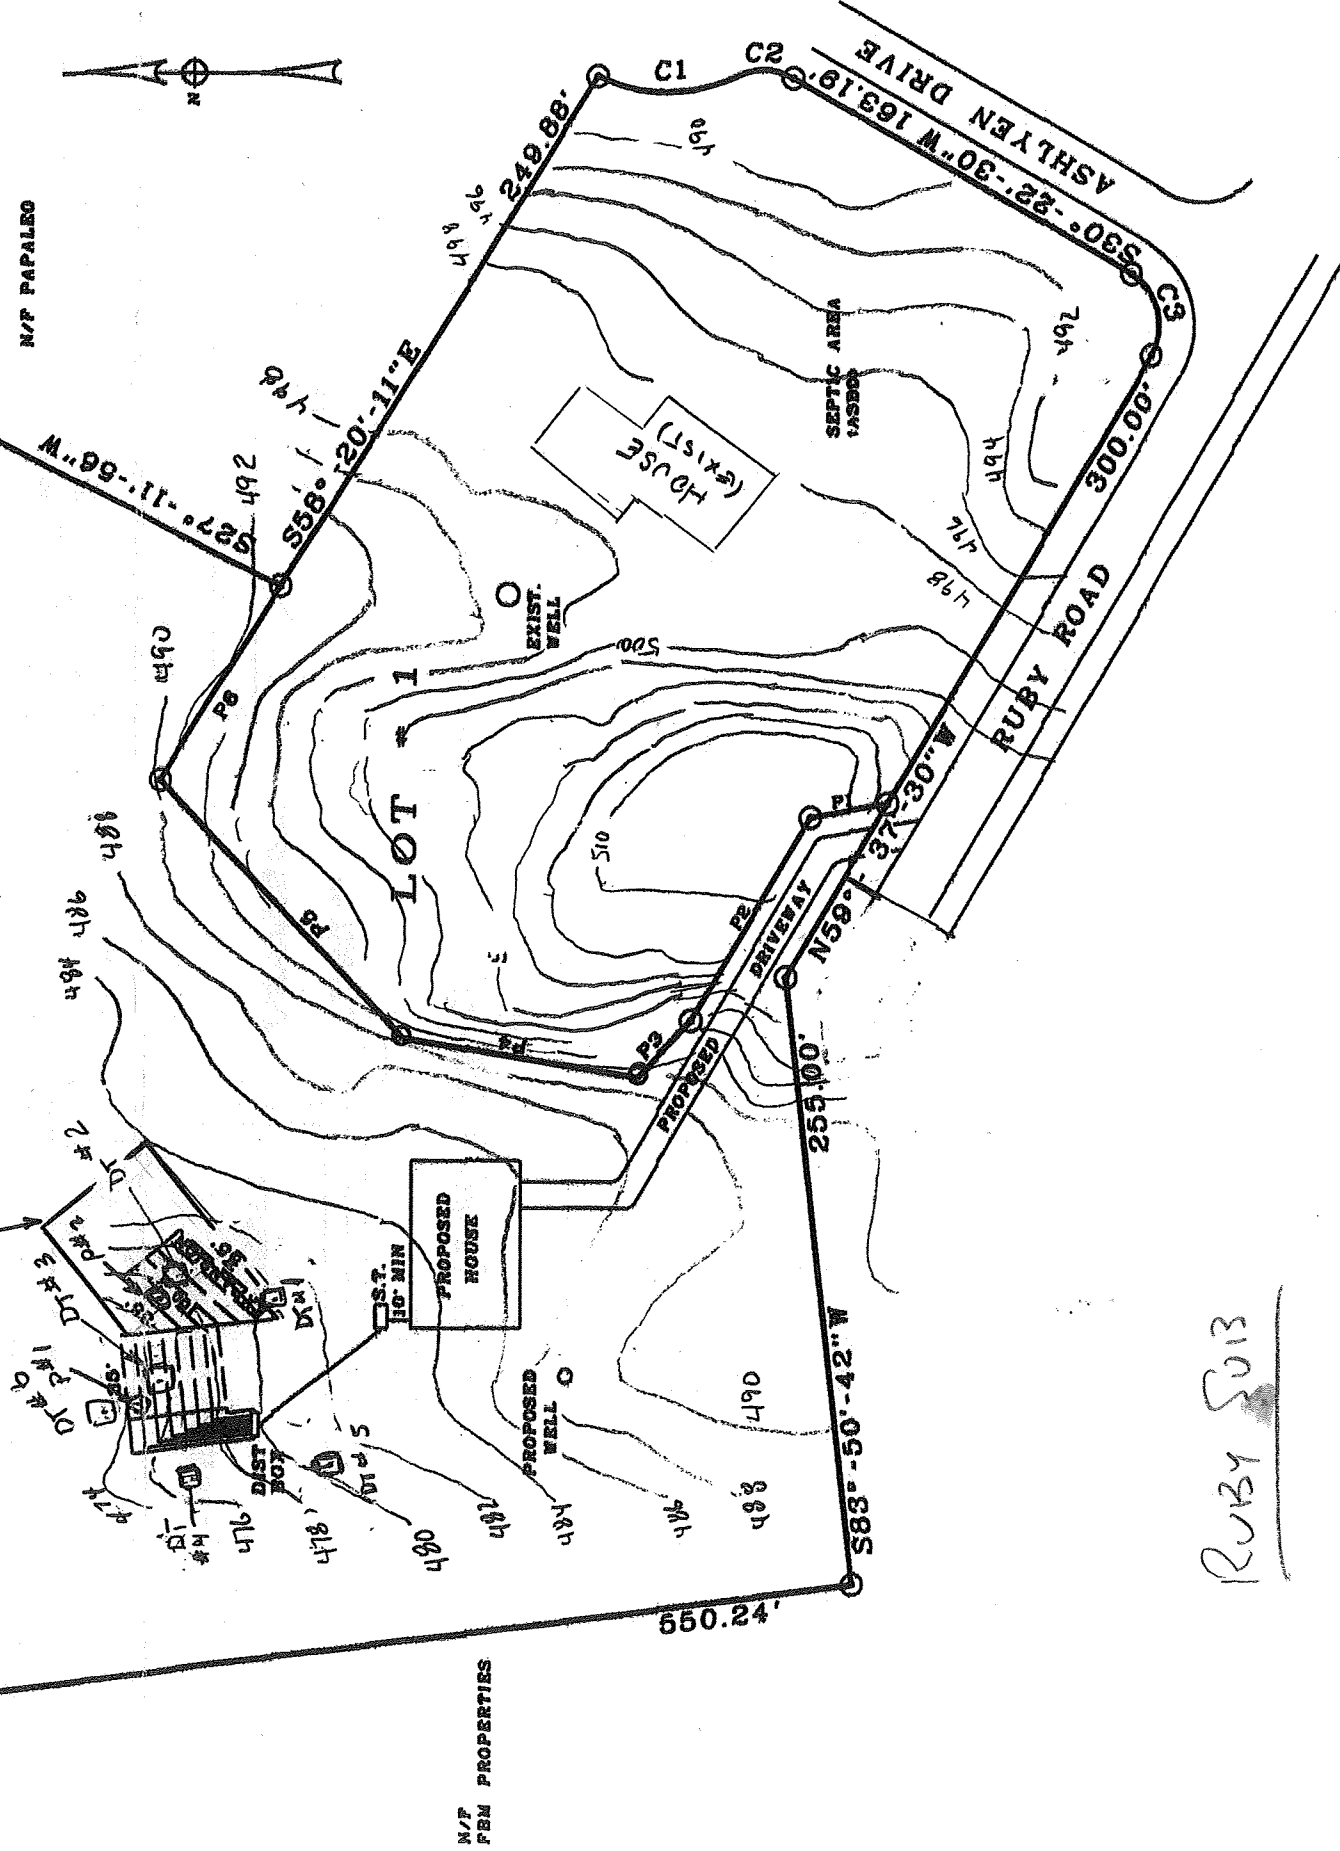

Ruby Sub

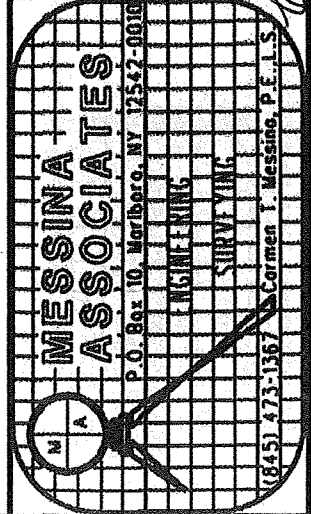

SEPTIC DESIGN FOR TODD DIORIO

TOWN OF MARLBORO ULSTER COUNTY NEW YORK
SCALE: 1" = 80'
DATE: 1/4/2022
DESIGN FOR LOT #2 FOR PROPOSED SUBDIVISION FOR ALAN & KATHERINE GUARINO CURRENTLY BEFORE MARLBORO NY PB